


Legend

- Section 36 consent boundary
- Consented turbine locations
- Existing haul road
- Proposed access track
- ScottishPower Transmission (SPT) substation
- Galawhistle Wind Farm Limited substation
- Statcom compound
- Galawhistle Wind Farm Limited temporary construction compound
- SPT temporary construction compound
- Crane pads
- Permanent met mast
- Borrow pit (BP)
- Borrow pit working/storage area

Notes:

1. Turbines and met mast consented locations have not changed.
2. Turbines 17, 18, 19 and 21 have maximum consented tip height of 121.2m. All other turbines have maximum consented tip height of 110.2m. The maximum consented tip heights have not changed.
3. The red line S36 consented boundary has not changed.
4. Borrow pit locations have not changed. Working areas adjacent to borrow pits have been added.

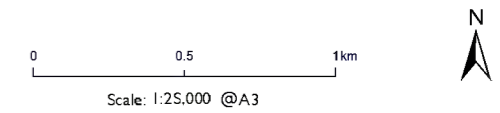

Rev	Date	Amendment	Drawn	Checked

Date: 02.09.14 Scale: 1:25,000 Ver: 1.0
 Job No: SEC7849 Drawn: KAG Checked: TT

Reproduced from Ordnance Survey digital map data
 © Crown copyright. All rights reserved 2013. Licence number: 0100031673

The Proposed Development

Figure No. 1a

**Galawhistle Wind Farm:
 S36 Variation Application 2014**